


As Built Floor Plan | Suite 210 | ±2,017 RSF

391 Taylor Boulevard, Pleasant Hill, CA

Key Plan

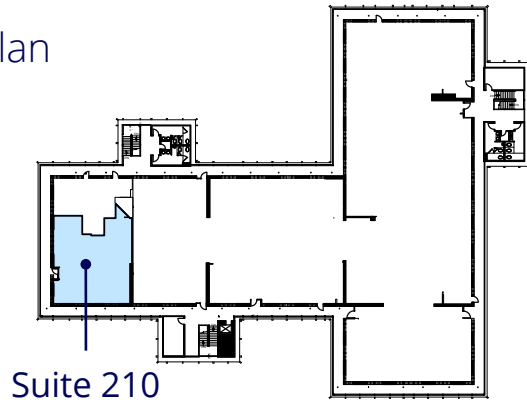

Site Plan

